



MD 190 IS ASSUMED TO RUN  
IN A EAST / WEST DIRECTION


### SIGNALS

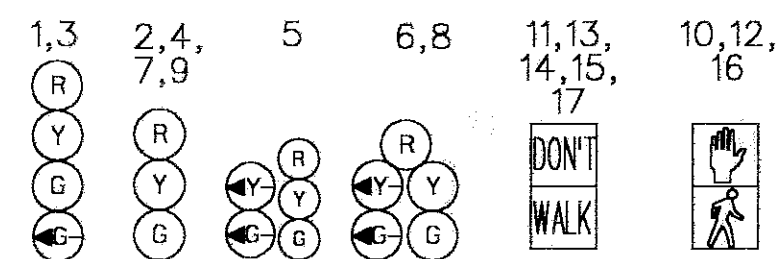

### SIGNS

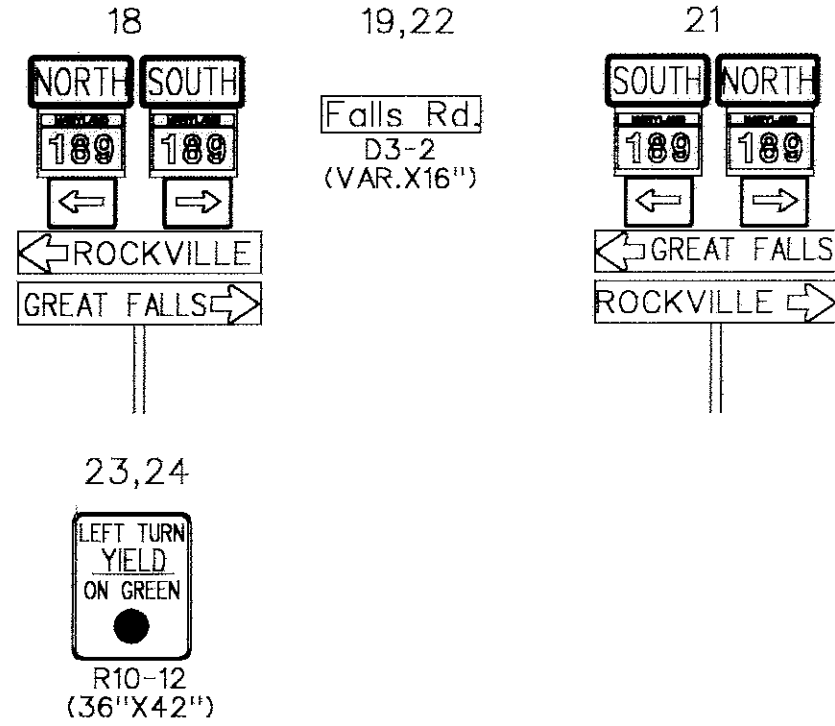

### PHASING

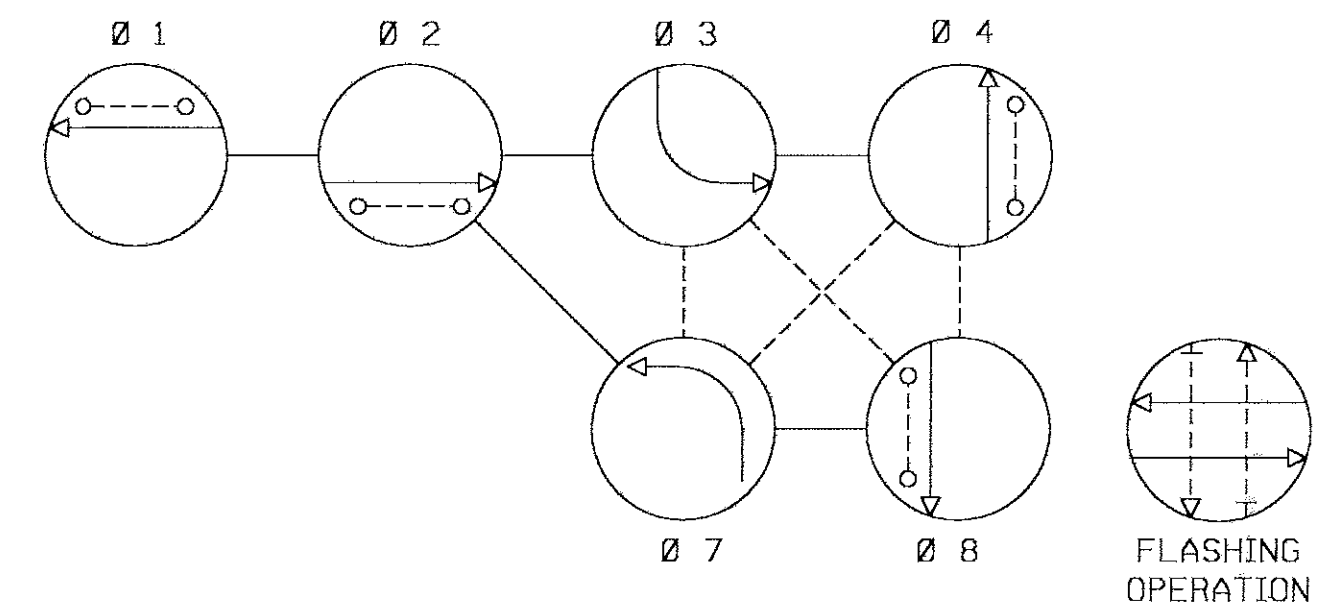

PHASING NOTES:  
1. PHASES ASSOCIATED BY A SOLID LINE WILL NOT OPERATE CONCURRENTLY.  
2. PHASES ASSOCIATED BY A DASHED LINE MAY/WILL OPERATE CONCURRENTLY.

OVERHEAD I/C WEST  
TO COUNCEL RD.

MD 190

MD 190


### EQUIPMENT DETAILS

- A. 12" x 30' steel strain pole, pedestrian signal heads and pushbutton with pedestrian education sign. (Note: 1-2" weatherhead, 1-2", 90° polyvinyl chloride (Schedule 80) bend.)
- B. 12" x 30' steel strain pole, pedestrian signal heads and pushbutton with pedestrian education sign. (Note: 1-2" weatherhead, 2-2", 90° polyvinyl chloride (Schedule 80) bend.)
- C. 12" x 40' steel pole, with camera and pole mounted cabinet. (Note: 2-2", 90° polyvinyl chloride (Schedule 80) bend.)
- D. 12"x30" steel strain pole, pedestrian signal heads and pushbutton with pedestrian education sign and meter socket with disconnect switch. (Note: 1-3" weatherhead and 1-2" weatherhead and 1-3" 90° polyvinyl chloride (Schedule 80) bend.)
- E. NEMA size "6" -mounted cabinet and controller with all necessary equipment. (Note: 1-2", 90° polyvinyl chloride (Schedule 80) bend, 1-4", 90° polyvinyl chloride (Schedule 80) bend and 2-2", 90° polyvinyl chloride (Schedule 80) bends.)
- F. 3/8" steel span wire, traffic signal heads and signs as shown.
- G. 6' x 22' loop detector encased in 1/4" flexible tubing quadrupole type (3-6-3).
- H. 6' x 6' loop detector encased in 1/4" flexible tubing (4-turns).
- J. Handhole.
- K. 2" galvanized steel electrical conduit.
- L. Overhead interconnect cable.
- M. 2" polyvinyl chloride electrical conduit (Schedule 80).
- N. 3" polyvinyl chloride electrical conduit (Schedule 80).
- O. Existing handhole with 2-4" electrical conduit. (Note: Handhole is in thick briar brush and it was not located during field check).
- P. Overhead electrical service by PEPCO.

### GENERAL NOTES:

1. This plan reflects only those utilities that were apparent at the time of this location being asbuilt. A detailed review was not undertaken and this plan should not be construed as representing all utilities in the area.
2. Any modification to this subject signal should be preceded by a thorough identification of all existing utilities.

REVISION "C" ASBUILT

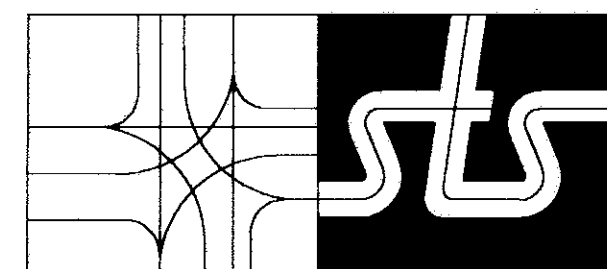

Gateway International  
1302 Concourse Drive, Suite 104  
Linthicum, Maryland 21090  
Ph (410) 859-3553  
Fax (410) 859-3579

34841.DGN

### REVISIONS

NO.	DESCRIPTION	DATE
©	ASBUILT	2/3/99
RRZ		
B	REPLACE LOOPS DUE TO RESURFACING SHA NO. M05715176	10/96
A	RECONSTRUCTION OF EXISTING SIGNAL FOR NEW GEOMETRICS	6/87
GEC		

### APPROVALS

ASST. CHIEF TRAFFIC SECTION
ASST. DISTRICT ENGINEER, TRAFFIC
CHIEF TRAFFIC ENGINEERING DESIGN DIVISION
DIRECTOR, TRAFFIC & SAFETY



**MARYLAND DOT - STATE HIGHWAY ADMINISTRATION**  
Office of Traffic & Safety  
**TRAFFIC ENGINEERING DESIGN DIVISION**  
**MD 190 (RIVER ROAD) AT MD 189 (FALLS ROAD)**

DRAWN BY: G. COOK  
CHECK BY:  
DATE: 10-17-84  
SCALE: 1"=20'

COUNTY: MONTGOMERY  
LOG MILE: 15018901.97  
F.A.P. NO.  
S.H.A. NO.

TS NO.  
TS-2022C  
T.I.M.S. NO.

SHEET NO.  
OF